
Fighting for Your Rights





PROPERTY ADDRESS: 6421 LAKE PATRICIA DRIVE MIAMI LAKES, FLORIDA 33014

SURVEY NUMBER: FL1704.3833

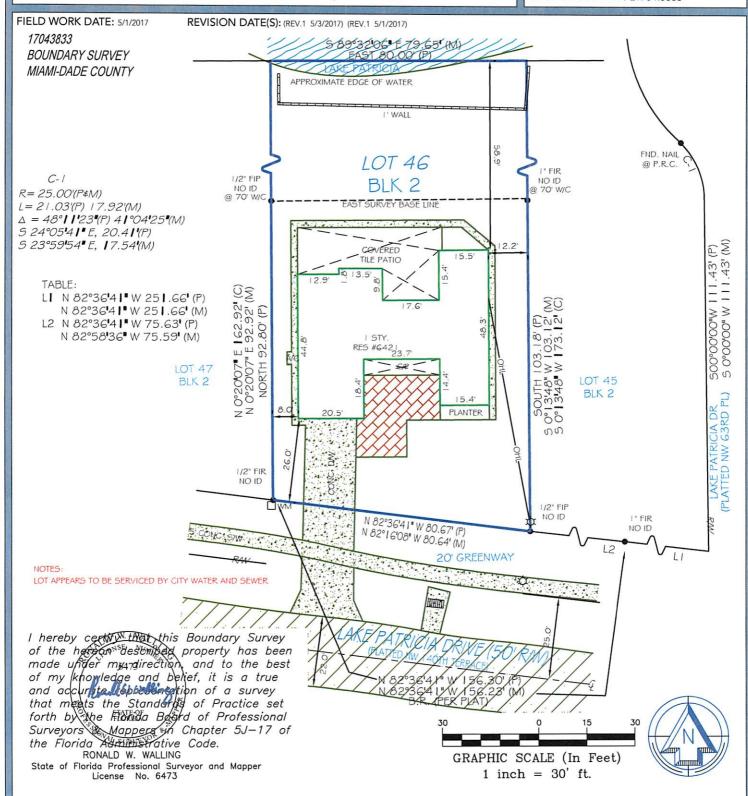

Use of This Survey for Purposes other than Intended, Without Written Verification, will be at the User's Sole Risk and Without Liability to the Surveyor. Nothing hereon shall be Construed to Give ANY Rights or Benefits to Anyone Other than those Certified.

## FLOOD INFORMATION:

BY PERFORMING A SEARCH WITH THE LOCAL GOVERNING MUNICIPALITY OR WWW.FEMA.GOV, THE PROPERTY APPEARS TO BE LOCATED IN ZONE X. THIS PROPERTY WAS FOUND IN THE TOWN OF MIAMI LAKES, COMMUNITY NUMBER 120686, DATED 09/11/09.

CLIENT NUMBER: 17-0393P

DATE: 5/1/2017

BUYER: RUBEN ARGUELLES

SELLER: HENRY MANFREDIZ AND ELIZABETH PRATS

CERTIFIED TO: RUBEN ARGUELLES; FRIEDLAND AND ASSOCIATES, PA; OLD REPUBLIC NATIONAL TITLE INSURANCE COMPANY; CALIBER HOME LOANS, INC.; ITS SUCCESSORS AND/OR ASSIGNS; AS THEIR INTERESTS MAY APPEAR

This is page 1 of 2 and is not valid without all pages.

POINTS OF INTEREST NONE VISIBLE



AFFILIATE MEMBERS



www.exactaland.com P.866-735-1916 • F.866-744-2882

LB# 7337

• P.866-735-1916 • F.866-744-2882 11940 Fairway Lakes Drive, Suite 1 • Ft. Myers, FL 33913

LOT 46, IN BLOCK 2, OF MIAMI-LAKES SECTION ONE, ACCORDING TO THE PLAT THEREOF, AS RECORDED IN PLAT BOOK 75, AT PAGE 35, OF THE PUBLIC RECORDS OF MIAMI-DADE COUNTY FLORIDA.

### JOB SPECIFIC SURVEYOR NOTES:

THE BEARING REFERENCE OF NORTH 82 DEGREES 36 MINUTES 41 SECONDS WEST IS BASED ON THE NORTHEASTERLY RIGHT-OF-WAY LINE OF LAKE PATRICIA DRIVE, LOCATED WITHIN MIAMI LAKES, SECTION ONE ACCORDING TO THE PLAT THEREOF, AS RECORDED IN PLAT BOOK 75, PAGE 35 OF THE PUBLIC RECORDS OF MIAMI-DADE COUNTY, FLORIDA.

### **GENERAL SURVEYOR NOTES:**

- The Legal Description used to perform this survey was supplied by others. This survey does not determine or imply ownership.

  This survey only shows improvements found above ground. Underground footings, utilities and encroachments are not located on this survey map.

  If there is a septic tank, or drain field shown on this survey, the location is approximate as the location was either shown to Exacta by a third party or it was estimated by metal detection, probing rods, and visual above ground inspection only. No excavation was performed in order to determine the exact and accurate location.

  This survey is exclusively for the use of the parties to whom it is certified.

  Additions or deletions to this survey map and report by other than the signing party or parties is prohibited without written consent of the signing party or parties.

  Dimensions are in feet and decimals thereof.

- Due to varying construction standards, house dimensions are approximate.

ETYPES: (UNLESS OTHE BOUNDARY LINE

- Due to varying construction standards, house dimensions are approximate.
   Any FEMA flood zone data contained on this survey is for informational purposes only. Research to obtain such data was performed at www.fema.gov.
   All corners marked as set are at a minimum a %"diameter, 18" iron rebar with a cap stamped LB#7337.
   If you are reading this survey in an electronic format, the information contained on this document is only valid if this document is electronically signed as specified in Chapter 5J-17.062 (3) of the Florida Administrative Code and Florida Statute 472.025. The Electronic Signature File related to this document is prominently displayed on the invoice for this survey which is sent under separate cover. Manually signed and sealed logs of all survey signature files are kept in the office of the performing surveyor. If this document is in paper format, it is not valid without the signature and original raised seal of a Florida Licensed Surveyor.
   Unless otherwise noted, an examination of the abstract of title was NOT performed by the signing surveyor to determine which instruments, if any, are affecting this property.
   The symbols reflected in the legend and on this survey may have been enlarged or reduced for clarity. The symbols have been plotted at the center of the field location, and may not represent the actual shape or size of the feature.
   Points of Interest (POI's) are selected above-ground improvements which may be in conflict with houndary, building setback or exament lines.


- 13. Points of Interest (POI's) are selected above-ground improvements which may be in conflict with boundary, building setback or easement lines
- as defined by the parameters of this survey. There may be additional POI's which are not shown, not called-out as POI's, or which are otherwise unknown to the surveyor. These POI's may not represent all items of interest to the viewer.

  14. Utilities shown on the subject property may or may not indicate the existence of recorded or unrecorded utility easements.

  15. The information contained on this survey has been performed exclusively, and is the sole responsibility, of Exacta Surveyors. Additional logo or references to third party firms are for informational purposes only.
- Pursuant to F.S. 558.0035, an individual employee or agent may not be held individually liable for negligence.
   House measurements should not be used for new construction or planning. Measurements should be verified prior to such activity.

#### LEGEND:

# SURVEYOR'S LEGEND

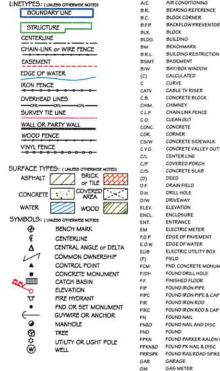

	AIR CONDITIONING	ID.	IDENTIFICATION
	BEARING REFERENCE	ILL.	ILLEGIBLE
	BLOCK CORNER	INST.	INSTRUMENT
e	BACKFLOW PREVENTOR	INT.	INTERSECTION
	BLOCK	L	LENGTH
G.	BUILDING	LB#	LICENSE # - BUSINESS
	BENCHMARK	LS#	LICENSE # - SURVEYOR
L	BUILDING RESTRICTION LINE	(M)	MEASURED
AT.	BASEMENT	M.B.	MAP BOOK
	BAY/BOX WINDOW	M.E.S.	MITERED END SECTION
	CALCULATED	M.F.	METAL FENCE
	CURVE	N.R.	NON RADIAL
V	CABLE TV RISER	N.T.S.	NOT TO SCALE
	CONCRETE BLOCK	O.C.5.	ON CONCRETE SLAB
u.	CHIMNEY	O.G.	ON GROUND
6	CHAIN LINK FENCE	OFF	OUTSIDE OF SUBJECT PARCEL
	CLEAN OUT	OH.	OYERHANG
IC.	CONCRETE	OHL	OVERHEAD LINES
	CORNER	ON	INSIDE OF SUBJECT PARCEL
W	CONCRETE SIDEWALK	ORB	OFFICIAL RECORD BOOK
3.	CONCRETE VALLEY GUTTER	O.R.V.	OFFICIAL RECORD VOLUME
	CENTER LINE	O/A	OVERALL
	COVERED PORCH	0/9	OFFSET
	CONCRETE SLAB	(P)	PLAT
	DEED	P.B.	PLAT BOOK
	DRAIN FIELD	P.C.	POINT OF CURVATURE
	DRILL HOLE	P.C.C.	POINT OF COMPOUND CURVATURE
	DRIVEWAY	P.C.P.	PERMANENT CONTROL POINT
V	ELEVATION	P/E	POOL EQUIPMENT
L.	ENCLOSURE	PG.	PAGE
	ENTRANCE	P.L	POINT OF INTERSECTION
	ELECTRIC METER	PLS	PROFESSIONAL LAND SURVEYOR
	EDGE OF PAVEMENT	PLT	PLANTER
w.	EDGE OF WATER	P.O.B.	POINT OF BEGINNING
	ELECTRIC UTILITY BOX	PO.C.	POINT OF COMMENCEMENT
	FIELD	P.P.	PNCHED POPE
í.	FND. CONCRETE MONUMENT	P.R.C.	POINT OF REVERSE CURVATURE
4	FOUND DRILL HOLE	PRM.	PERMANENT REFERENCE MONUMENT
	FINISHED FLOOR	PSM	PROFESSIONAL SURVEYOR AND
	FOUND IRON PIPE		MAPPER
	FOUND IRON PIPE & CAP		
	FOUND IRON ROD	P.T.	POINT OF TANGENCY
3	FOUND IRON ROD & CAP	R	RADIUS or RADIAL
	FOUND NAIL	(R)	RECORD
D	FOUND NAIL AND DISC	RGE.	RANGE
100	FOUND	RES.	RESIDENCE
N	FOUND PARKER-KALON NAIL	R/W	RIGHT OF WAY
NAD	FOUND PK NAIL & DISC	(5)	SURVEY
SPK	FOUND RAILROAD SPIKE	S.B.L.	SET BACK LINE
	GARAGE	S.C.L.	SURVEY CLOSURE LINE

S/GD	SET GLUE DISC
SIRC	SET IRON ROD & CAP
SN&D	SET NAIL & DISC
SQ.FT.	SQUARE FEET
STY.	STORY
S.T.L.	SURVEY TIE LINE
SV	SEWER VALVE
5/W	SIDEWALK
5.W.	SEAWALL
TBM	TEMPORARY BENCHMARK
TEL.	TELEPHONE FACILITIES
T.O.B.	TOP OF BANK
TWE	TOWNSHIP
TX	TRANSFORMER
TYP.	TYPICAL
U.R.	UTILITY RISER
W/C	WITNESS CORNER
W/F	WATER FILTER
W.F.	WOODEN FENCE
WM	WATER METER/VALVE BOX
wv	WATER VALVE
V.F.	VINYL FENCE
A.E.	ACCESS EASEMENT
AN.E.	ANCHOR EASEMENT
C.M.E.	CANAL MAINTENANCE ESMT.
C.U.E.	COUNTY UTILITY ESMT.
D.E.	DRAINAGE EASEMENT
D.U.E.	DRAINAGE AND UTILITY ESMT.
ESMT.	EASEMENT
LE/E.E.	INGRESS/EGRESS ESMT.
IRR.E.	IRRIGATION EASEMENT
LAE	LIMITED ACCESS ESMT.
L.B.E.	LANDSCAPE BUFFER ESMT.
L.E.	LANDSCAPE ESMT.
L.M.E.	LAKE OR LANDSCAPE
	MAINTENANCE EASEMENT
M.E.	MAINTENANCE EASEMENT
P.U.E.	PUBLIC UTILITY EASEMENT
R.O.E.	ROOF OVERHANG ESMT.
SWE	SIDEWALK EASEMENT

SEPTIC TA

# **ELECTRONIC SIGNATURE:**

In complete accordance with Florida Statute 472.025 and Pursuant to the Electronic Signature Act of 1996 or Florida Statute TITLE XXXIX, Chapter 668, if this document was received electronically via PDF, then it has been lawfully Electronically Signed. Therefore, this survey PDF, if authentic, is completely official and insurable. In order to validate the 'Electronic Signature' of PDF surveys sent via <a href="www.surveystars.com">www.surveystars.com</a>, you must use a hash calculator. A free hash calculator is available for download at:

rder to validate the Electronic Signature of any survey PDF sent via w.surveystars.com:

 Download the Hash Calculator available at: www.softpedia.com/get/System/File-Management/Hash-Calculator-Kir Save the Survey PDF onto your computer from www.surveystars.com or from the email sent from www.surveystars.com.

Click the square Browse button in the upper right hand corner of the Hash Calculator to find and select the saved Survey PDF document, and click the COMPUTE button in the lower right hand corner of the Hash Calculator.

4. Compare the 40 digit string of characters in the SHA-1 line to the 40 digit SHA-1 characters for the survey in the job file in www.surveystars.com which is also printed on the invoice for that survey.

5. If the 40 digit string of SHA-1 characters are exactly the same on the invo (or in the survey file at www.surveystars.com) as they are in the Hash Calcula then this PDF is authentic. If the 40 digit string of characters does not matexactly, then this PDF has been tampered with and it is not authen.

# PRINTING INSTRUCTIONS:

- 1. While viewing the survey in Adobe Reader, select the "Print" button under the "File" tab.
- 2. Select a printer with legal sized paper.
- 3. Under "Print Range", click select the "All" toggle
- 4. Under the "Page Handling" section, select the number of copies that you would like to print.
- 5. Under the "Page Scaling" selection drop down menu, select "None."
- 6. Uncheck the "Auto Rotate and Center" checkbox.
- 7. Check the "Choose Paper size by PDF" checkbox.
- 8. Click OK to print.

## TO PRINT IN BLACK + WHITE:

- 1. In the main print screen, choose "Properties".
- 2. Choose "Quality" from the options.
- 3. Change from "Auto Color" or "Full Color" to "Gray Scale".

OFFER VALID ONLY FOR: RUBEN ARGUELLES





Exacta Land Surveyors, Inc.

P.866-735-1916 • F.866-744-2882 11940 Fairway Lakes Drive, Suite 1. Ft. Myers, FL 33913